

CONTRACT NO / TO NO: N62473-10-D-0808		PROJECT TITLE / LOCATION: Rad Remediation D-1, Phase II / HPNS		ITSI GILBANE PROJECT NO: 07204.0004	
Survey No.: 07204.0004-0959-INF		Date: 7/17/2014		Location: HPNS	
Chris Robbins				Ed Palser	
Tech Printed Name		Signature		RSO Printed Name	
				Signature	

Instrument(s)

Model	Serial	Cal Due Date	Probe Model	Probe Serial	Cal Due Date	BKG α	BKG β	BKG γ	BKG μr/Hr	Eff. α	Eff. β
19	286213	7/27/2014	N/A						5.4	N/A	
N/A											
N/A											

Survey Description / Map /Photo

Survey Unit

F

Trench #:

04-PDT-006

Soil Survey Units

D0018	D0024	D0030	N/A	N/A
N/A				N/A

(D0001 to D0042)

From the Bottom of Trench

Soil Compaction Lift From	0	ft to	1
Soil Compaction Lift From	1	ft to	2
Soil Compaction Lift From	2	ft to	3
Soil Compaction Lift From	3	ft to	4
Soil Compaction Lift From	4	ft to	5
Soil Compaction Lift From	5	ft to	6
Soil Compaction Lift From	6	ft to	7
Soil Compaction Lift From	7	ft to	8
Soil Compaction Lift From	8	ft to	9
Soil Compaction Lift From	9	ft to	10
Soil Compaction Lift From	10	ft to	11

μR/Hr	μR/Hr	μR/Hr	μR/Hr
6	7	7	7
7	6	7	7
7	7	7	6
6	5	7	6
6	6	6	5
N/A	N/A	N/A	N/A
↓	↓	↓	↓

Comments: Informational Survey During Backfill Operation. Dose rates taken at 1 meter above surface to support RESRAD model. Model 19 BKGD from taken from instrument set up sheet.

DATE: 12/11/2013
 DRAWN BY: J. GILBANE
 CHECKED BY: J. GILBANE
 PROJECT: PARCEL D-1, PHASE II
 SHEET: 1 OF 2



Sheet
 reference
 number:
 1 of 2

VERIFY SCALE
 BAR IS ONE INCH ON
 ORIGINAL DRAWING
 IF NOT ONE INCH ON
 THIS SHEET, ADJUST
 SCALE ACCORDINGLY


RADIOLOGICAL REMEDIATION AND SUPPORT
 PARCEL D-1, PHASE II
 HUNTERS POINT NAVAL SHIPYARD
 SAN FRANCISCO, CALIFORNIA

AS-BUILT PLANS
 DECEMBER 2013

TRENCH EXCAVATION
 LAYOUT PLAN

TSGilbane
 2730 Shadelands Drive
 Walnut Creek, CA 94598

- LEGEND**
- PARCEL D-1 BOUNDARY
 - SCOPE
 - █ TRENCH SURVEY UNIT

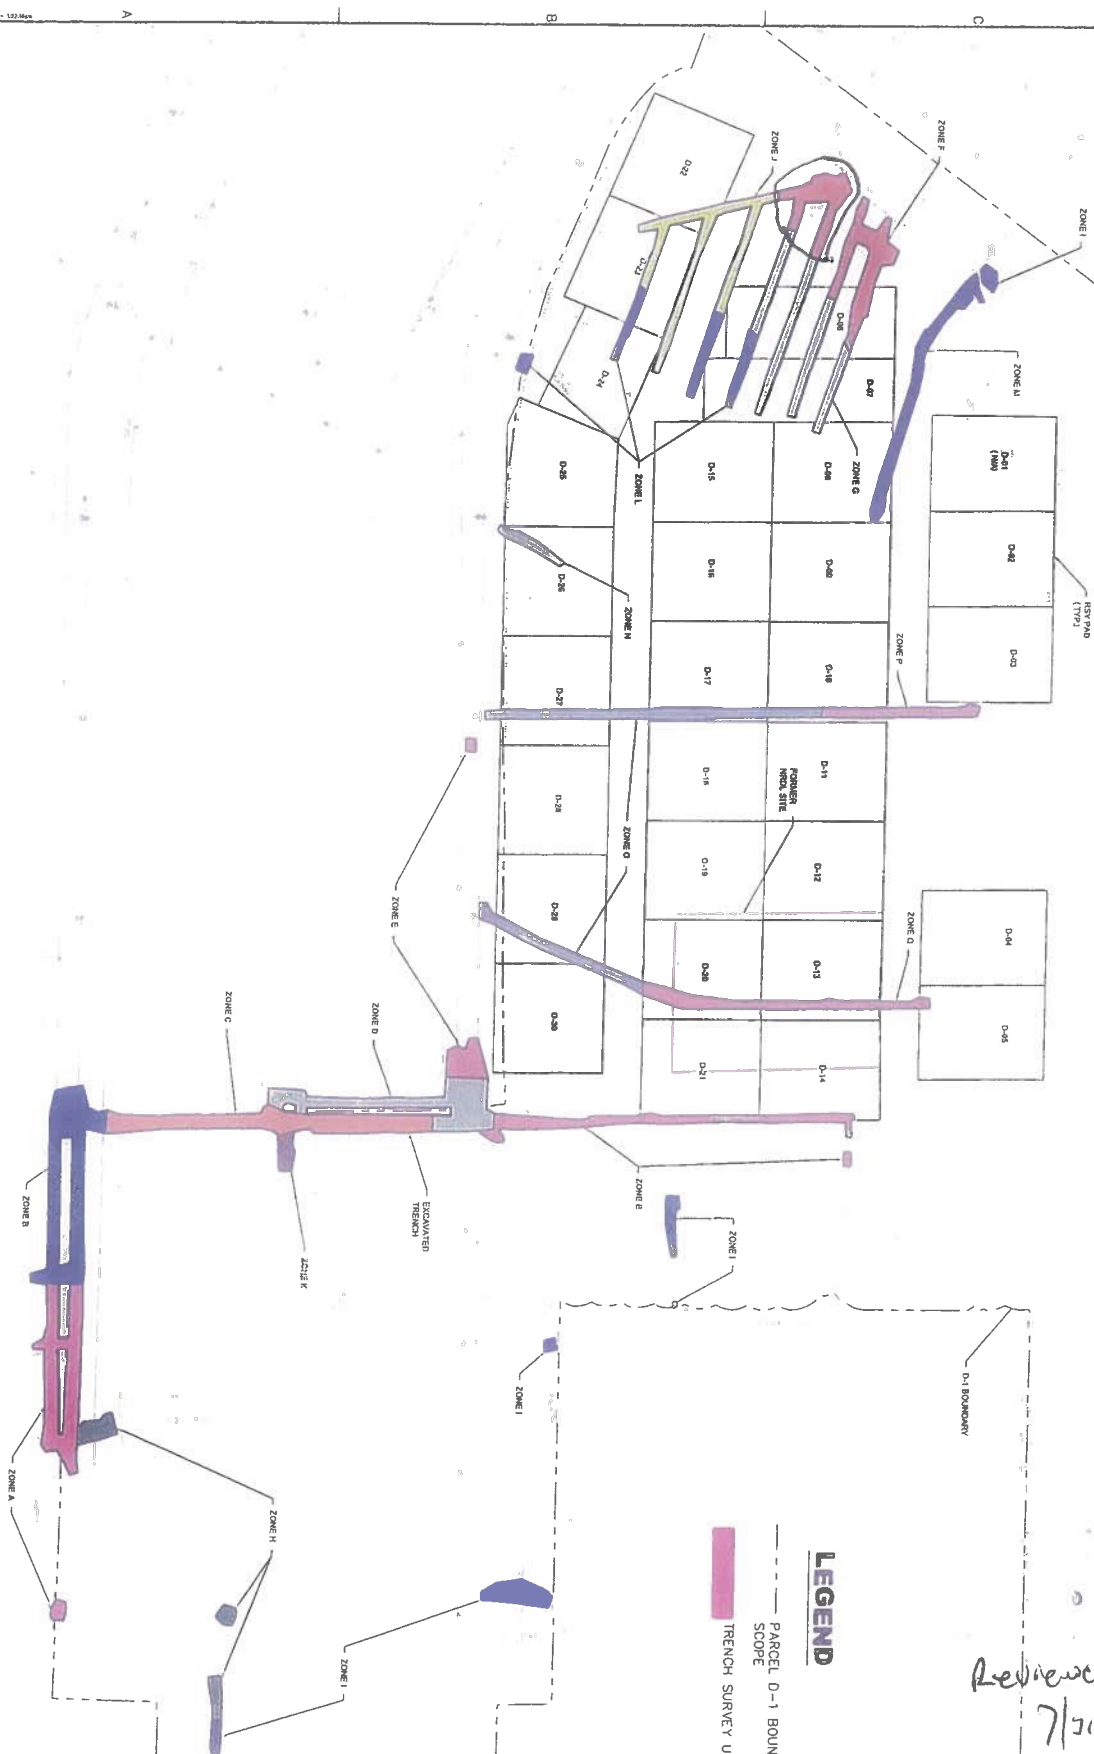

Reviewed
7/1/14
[Signature]

CONTRACT NO / TO NO: N62473-10-D-0808		PROJECT TITLE / LOCATION: Rad Remediation D-1, Phase II / HPNS		ITSI GILBANE PROJECT NO: 07204.0004	
Survey No.: 07204.0004-0959-INF		Date: 7/17/2014		Location: HPNS	
Chris Robbins				Ed Palser	
Tech Printed Name		Signature		RSO Printed Name	
				Signature	

Instrument(s)

Model	Serial	Cal Due Date	Probe Model	Probe Serial	Cal Due Date	BKG α	BKG β	BKG γ	BKG μr/Hr	Eff. α	Eff. β
19	286213	7/27/2014	N/A						5.4	N/A	
N/A											
N/A											

Survey Description / Map /Photo

Survey Unit

F

Trench #:

04-PDT-006

Soil Survey Units

D0018	D00245	D0030	N/A	N/A
N/A				N/A

(D0001 to D0042)


From the Bottom of Trench

Soil Compaction Lift From
Soil Compaction Lift From
0	ft to	1
1	ft to	2
2	ft to	3
3	ft to	4
4	ft to	5
5	ft to	6
6	ft to	7
7	ft to	8
8	ft to	9
9	ft to	10
10	ft to	11

μR/Hr	μR/Hr	μR/Hr	μR/Hr
5	5	6	5
5	5	6	6
5	5	6	5
5	5	6	5
6	7	6	6
N/A	N/A	N/A	N/A
↓	↓	↓	↓

Comments: Informational Survey During Backfill Operation. Dose rates taken at 1 meter above surface to support RESRAD model. Model 19 BKGD from taken from instrument set up sheet.

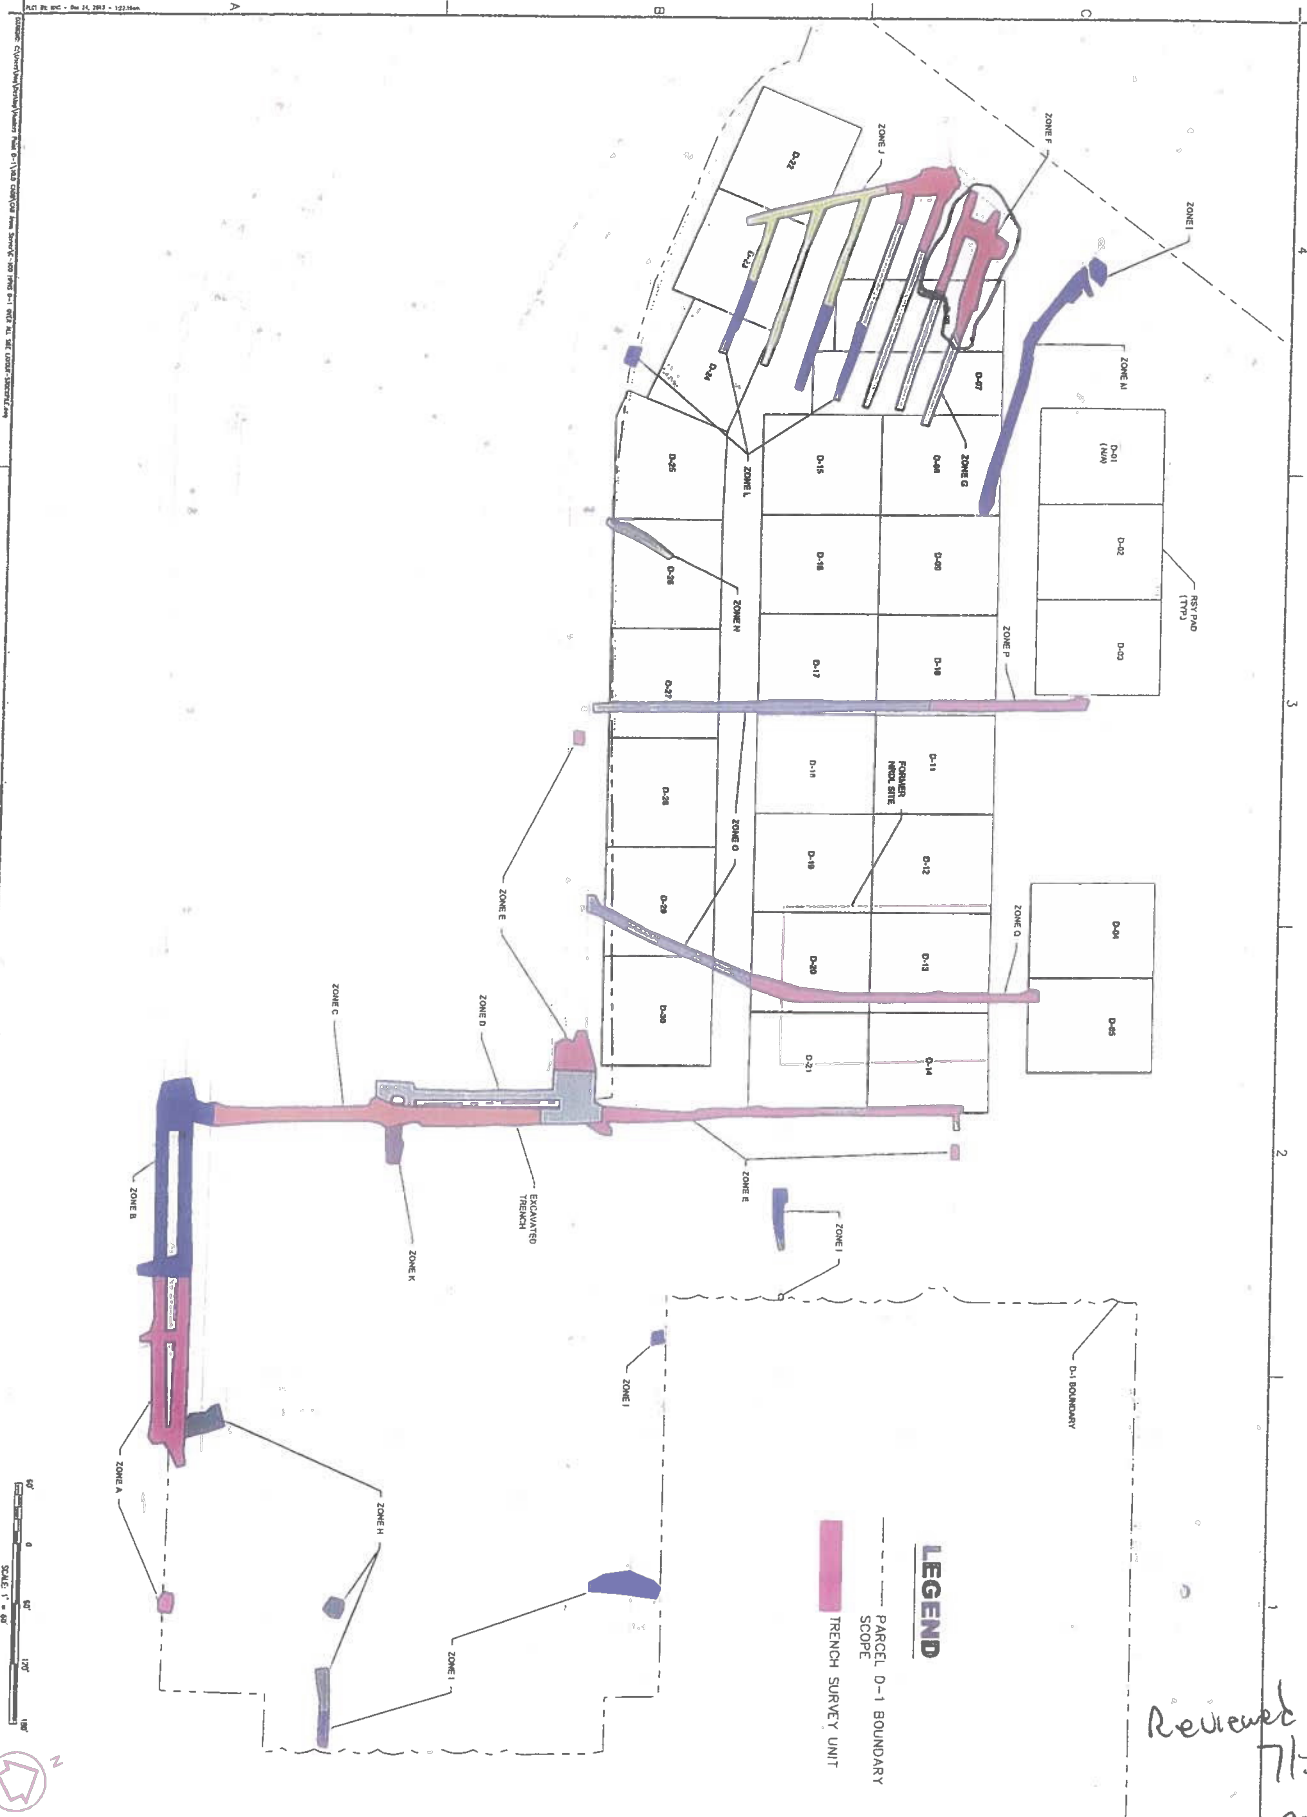

Reviewed
7/13/14
a

07204.0004-959-trf

Page 4 of 4